

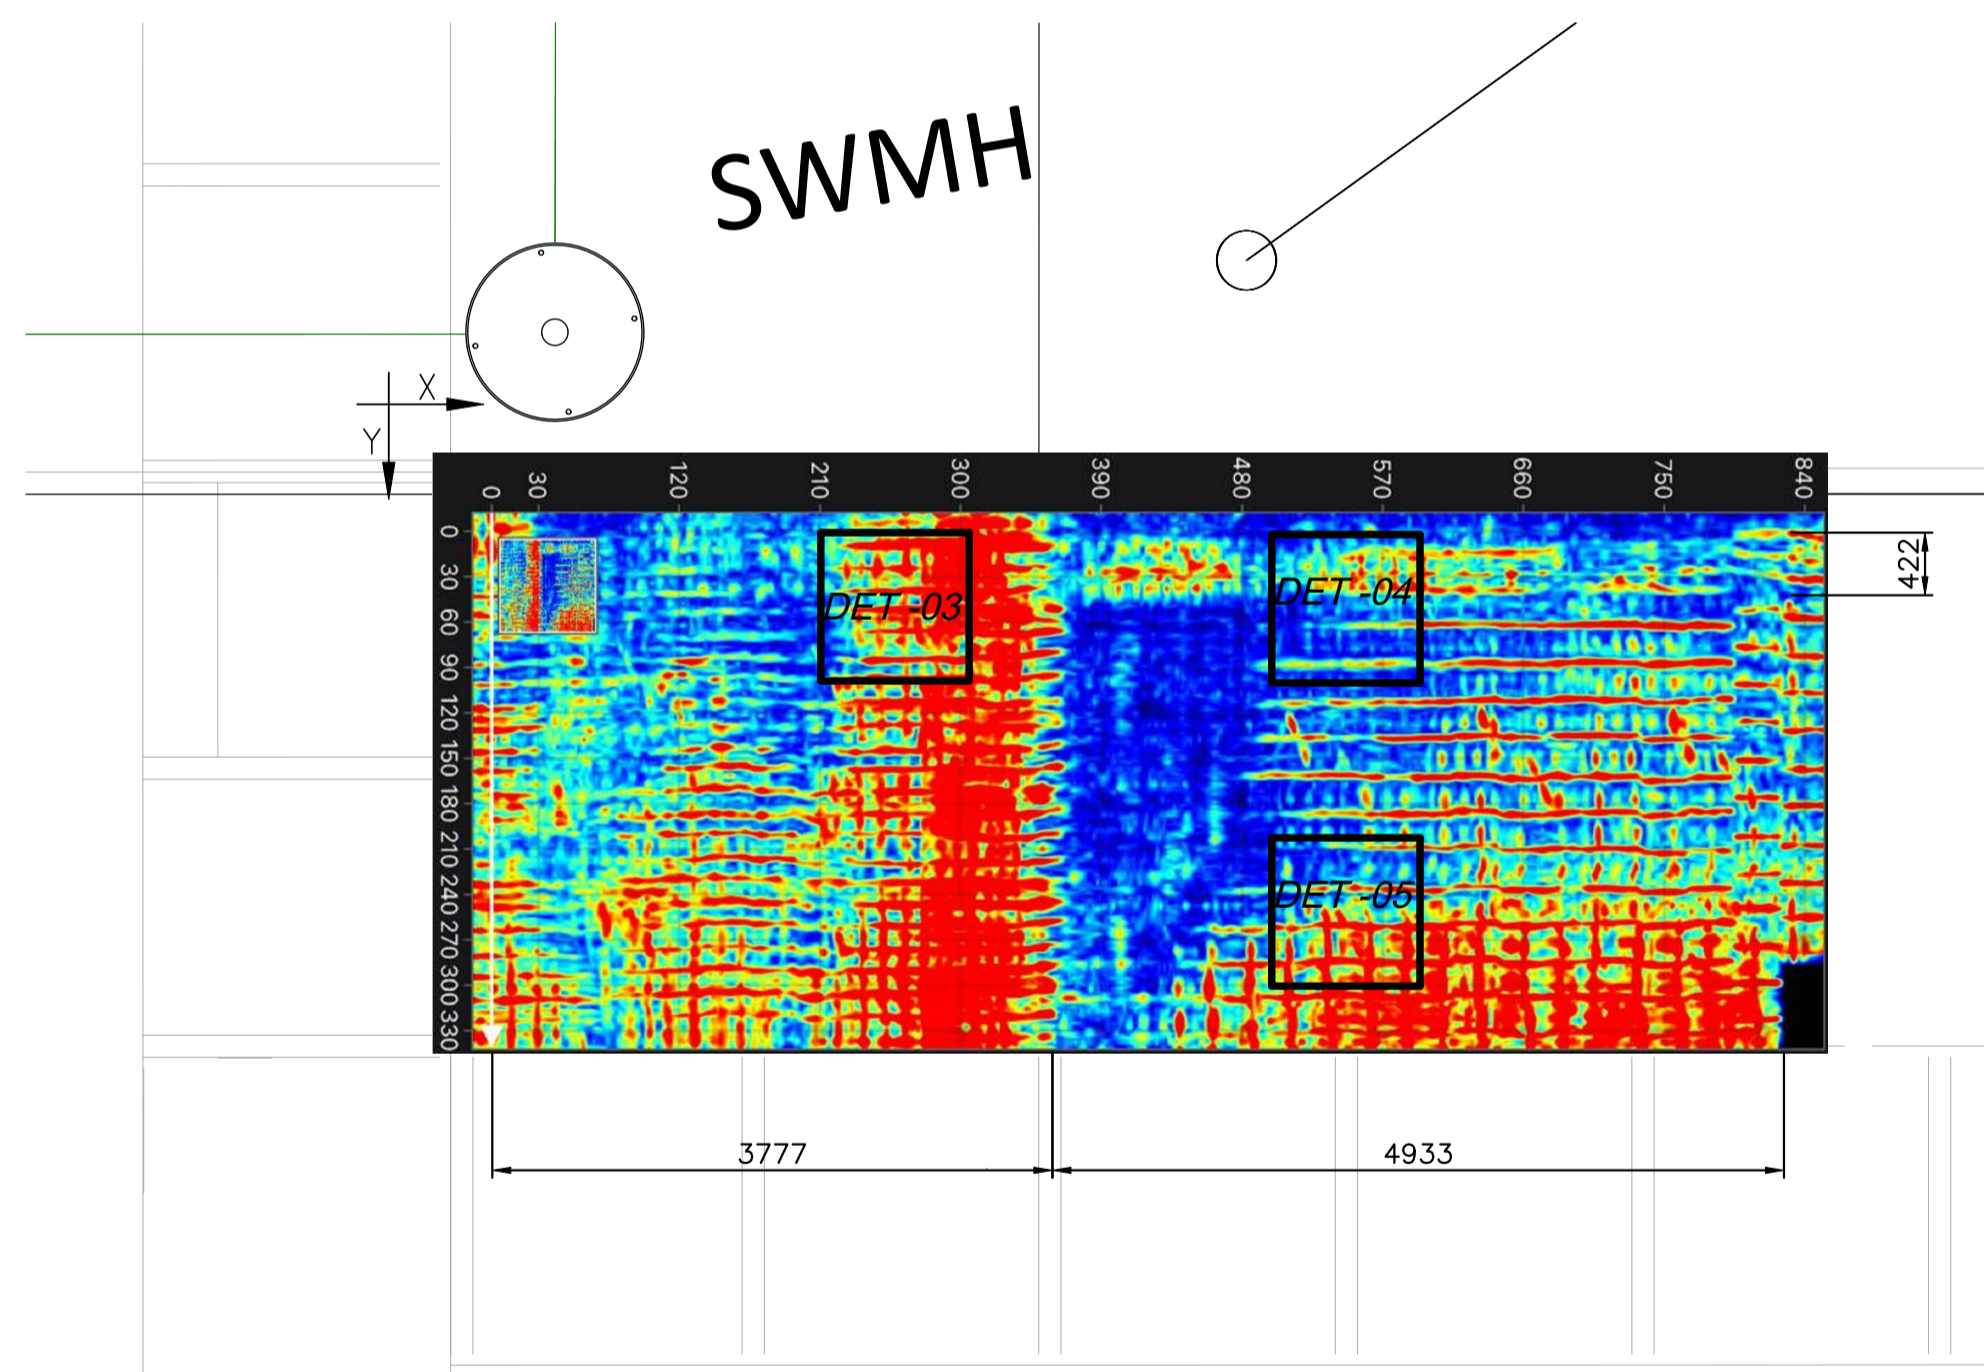
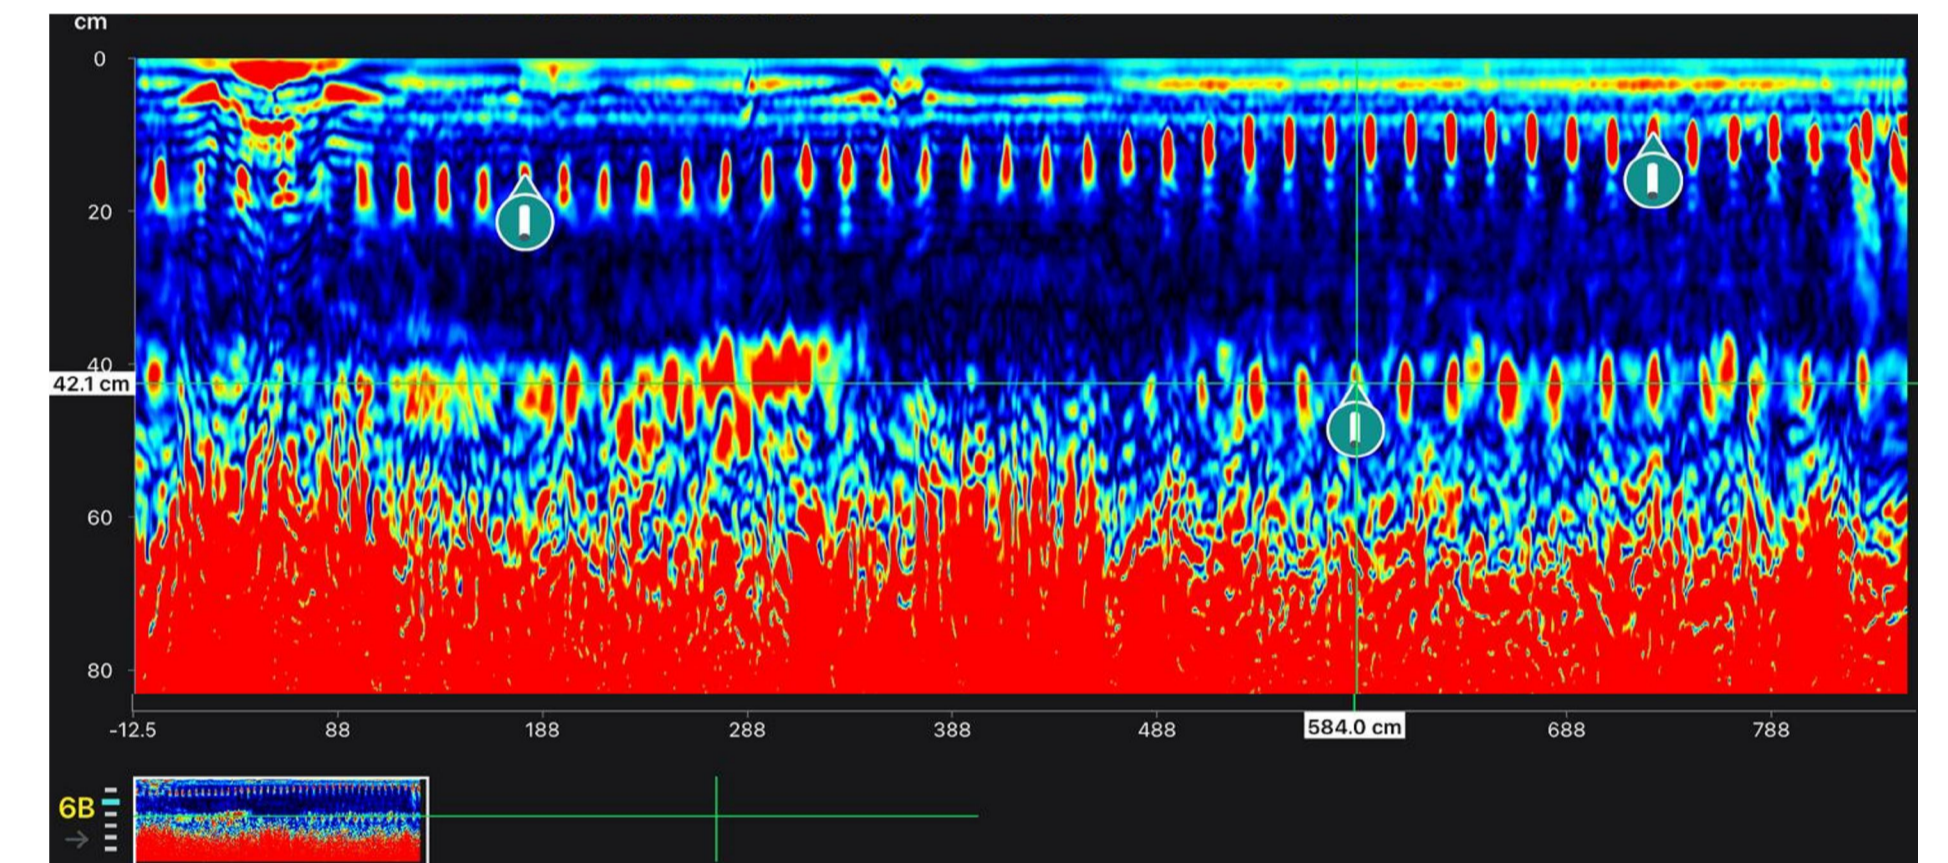
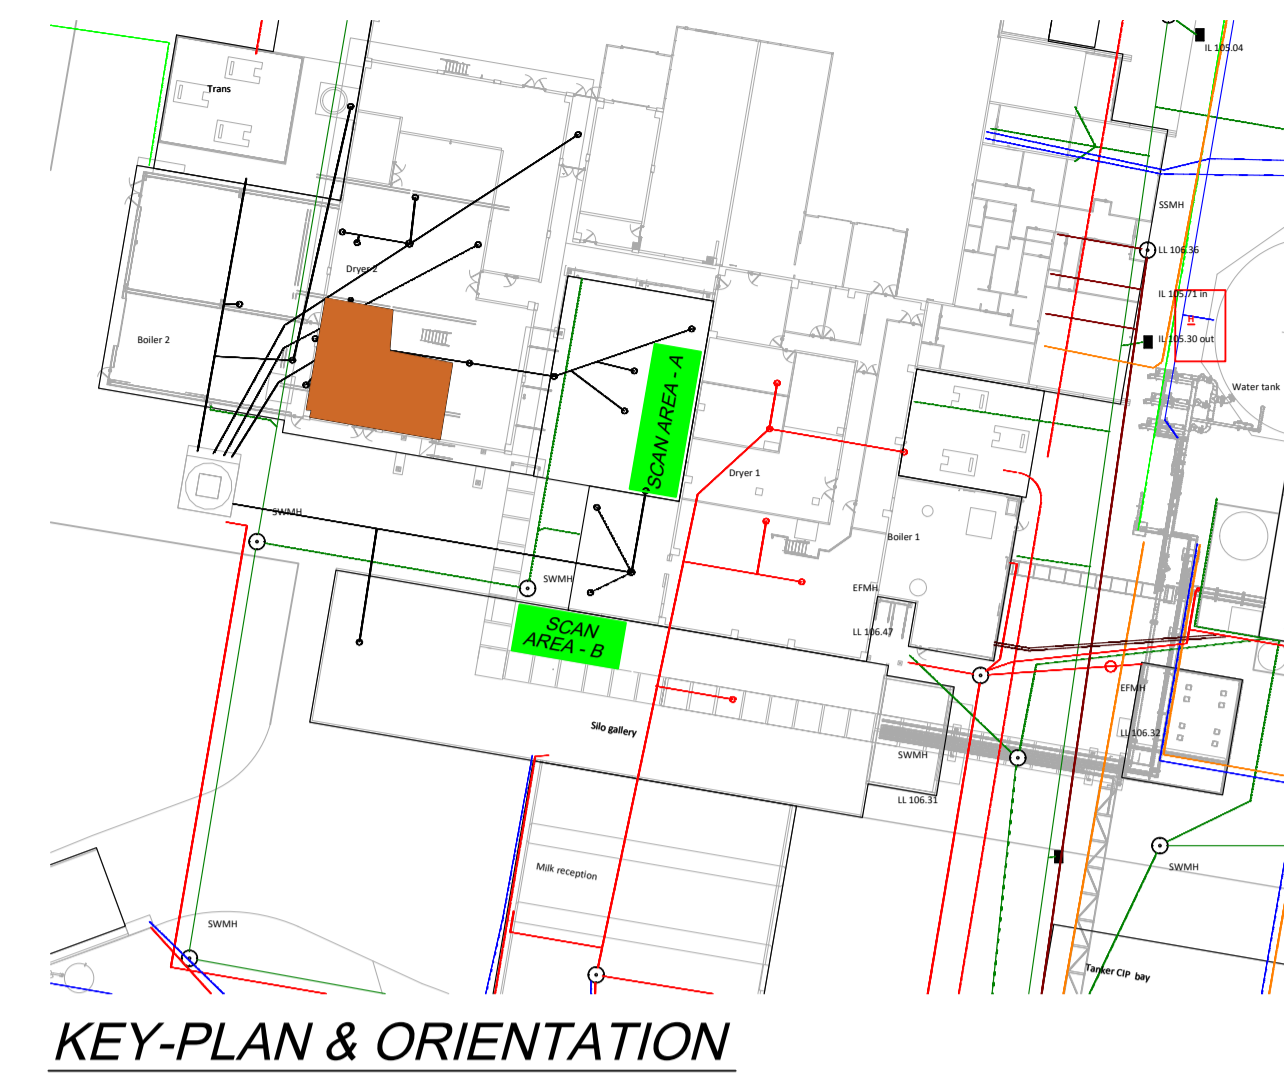
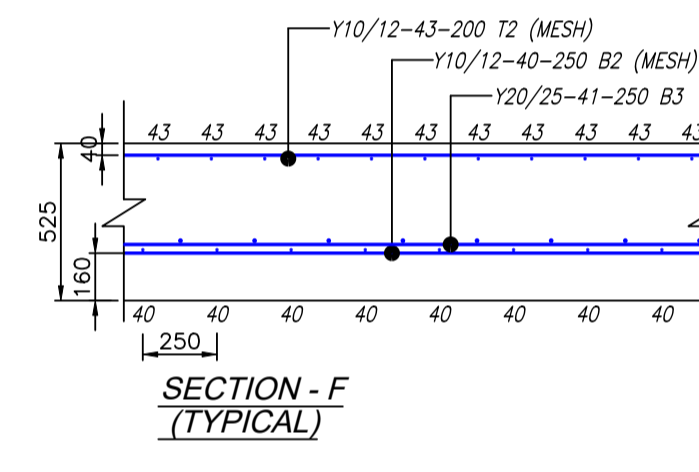
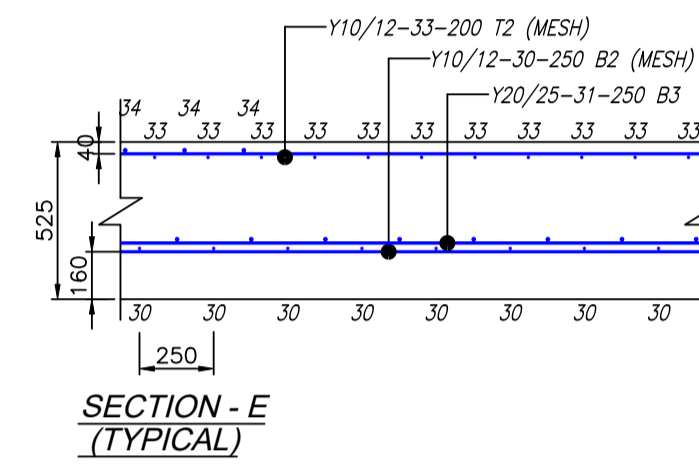
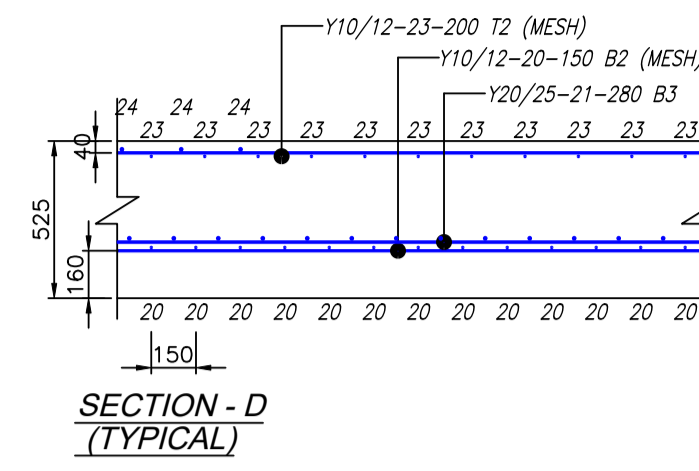
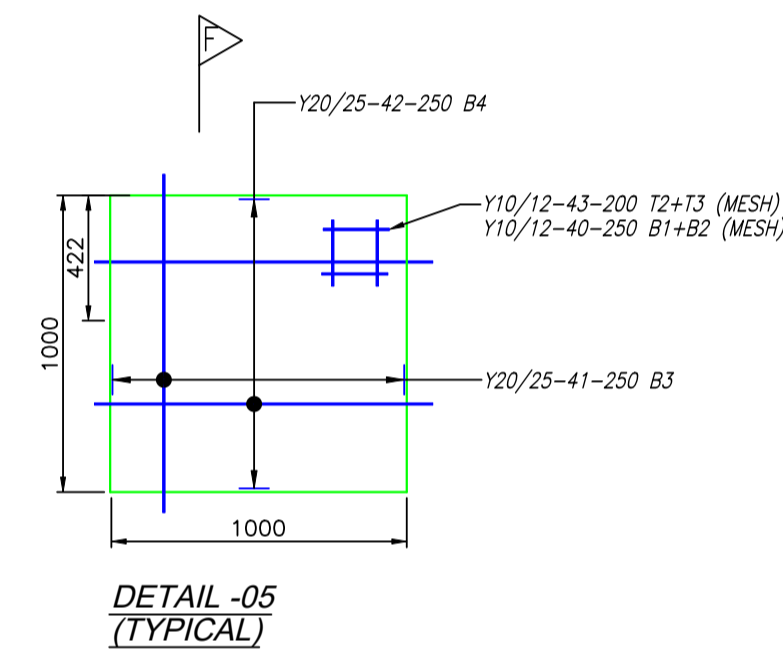



SCAN AREA -B (TOP REBAR)  
525 RC SURFACEBED SLAB

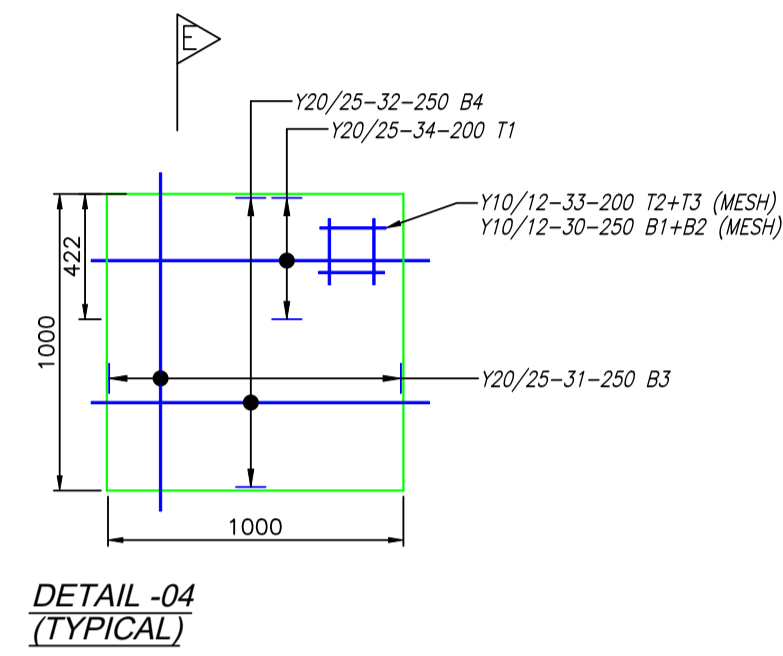

SCAN AREA -B (BOTTOM REBAR)  
525 RC SURFACEBED SLAB

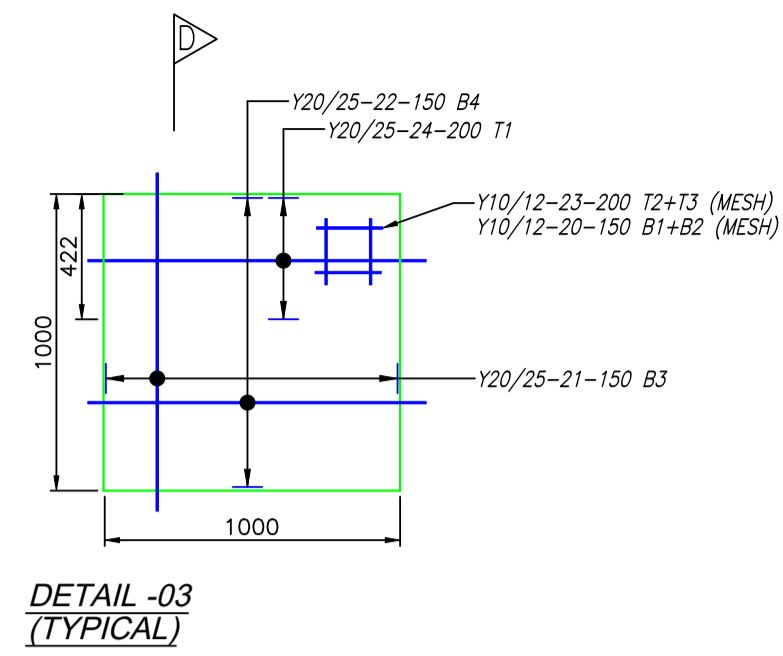

SECTION -G

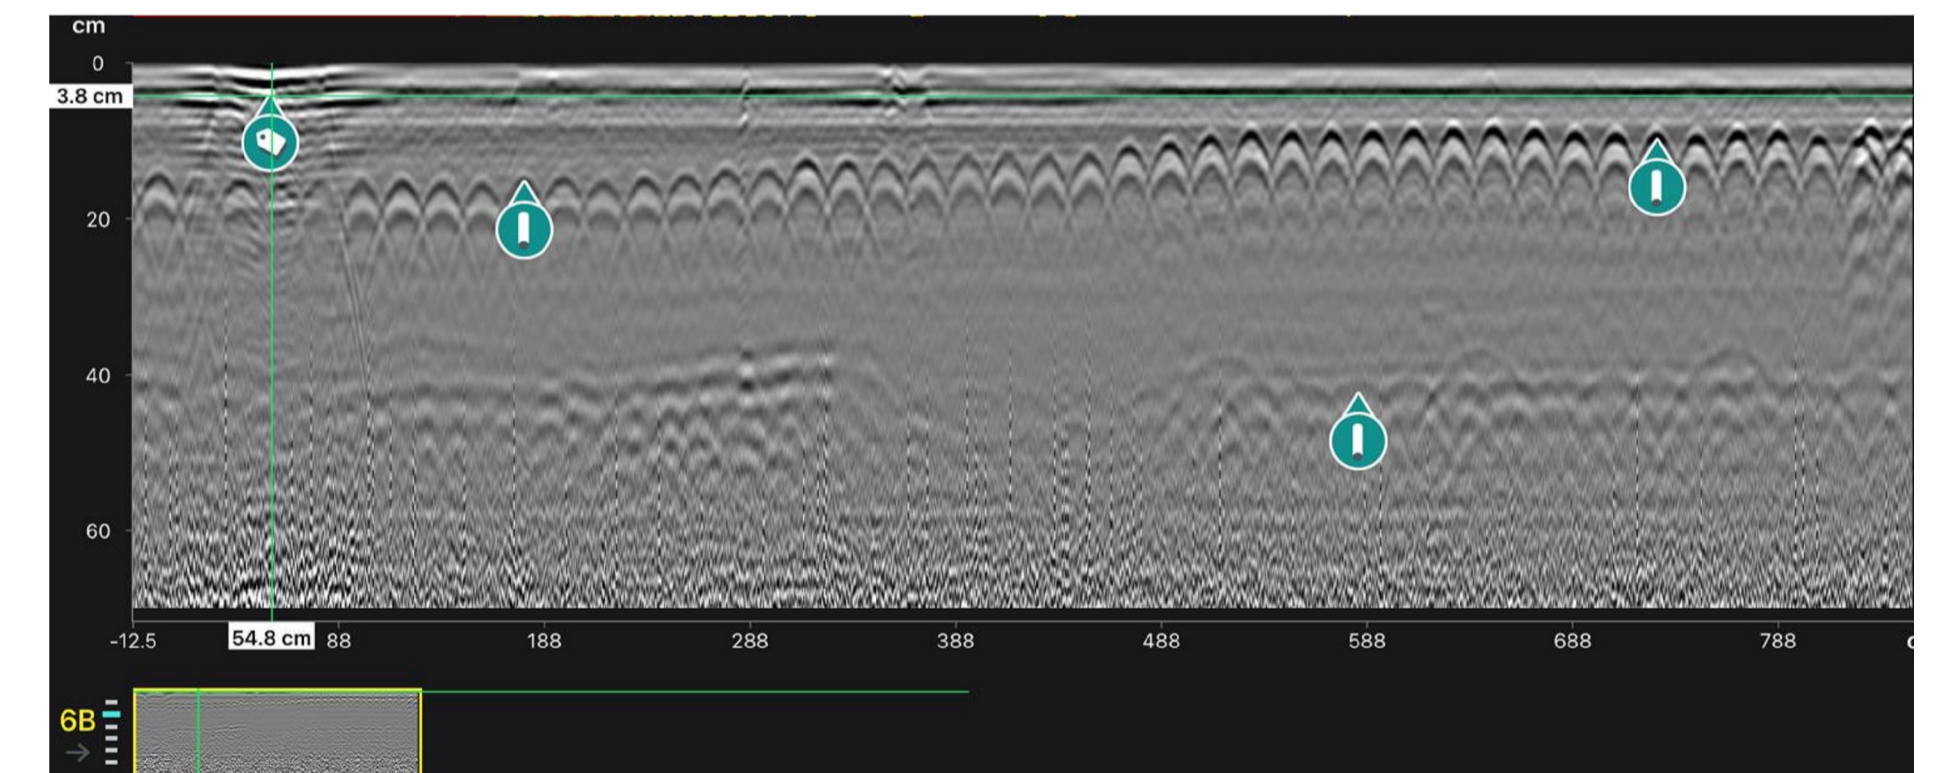

SECTION -G

LEGEND	PT SLAB (250mm)		This scan report is for information purposes only. Africa Utility Locators uses well trained staff and the best available technology available to compile this report. This report is only an interpretation of findings on site and can not be held responsible for any design errors based off of this report. Always proceed with caution while drilling and coring.
	RC SLAB (250mm)		
	PT TENDENS		

Scanned	Drawn	Checked	Approved	Date
	M.B.S			09 DEC 2024

CONTRACTOR

Advanced Scanning Solutions  
As Built/Make Easy

AS BUILT RECREATE SPECIALISTS  
0830098  
africanutilitylocators@gmail.com

RC SURFACEBED SCAN		
TANK BASE		
JOB NO.	DRAWING NO.	REVISION
A424	A424-GPR-01	0